



DEPARTMENT OF PERMITTING, ENVIRONMENT, AND REGULATORY
AFFAIRS (PERA)
BOARD AND CODE ADMINISTRATION DIVISION
NOTICE OF ACCEPTANCE (NOA)

MIAMI-DADE COUNTY
PRODUCT CONTROL SECTION
11805 SW 26 Street, Room 208
Miami, Florida 33175-2474
T (786) 315-2590 F (786) 315-2599
www.miamidade.gov/pera/

NR Architectural Products
4348 Westroads Drive
West Palm Beach, FL 33407

SCOPE:

This NOA is being issued under the applicable rules and regulations governing the use of construction materials. The documentation submitted has been reviewed and accepted by Miami-Dade County PERA -Product Control Section to be used in Miami Dade County and other areas where allowed by the Authority Having Jurisdiction (AHJ).

This NOA shall not be valid after the expiration date stated below. The Miami-Dade County Product Control Section (In Miami Dade County) and/or the AHJ (in areas other than Miami Dade County) reserve the right to have this product or material tested for quality assurance purposes. If this product or material fails to perform in the accepted manner, the manufacturer will incur the expense of such testing and the AHJ may immediately revoke, modify, or suspend the use of such product or material within their jurisdiction. PERA reserves the right to revoke this acceptance, if it is determined by Miami-Dade County Product Control Section that this product or material fails to meet the requirements of the applicable building code.

This product is approved as described herein, and has been designed to comply with the Florida Building Code, including the High Velocity Hurricane Zone.

DESCRIPTION: Series "6001" Aluminum Sliding Glass Doors – S.M.I.

APPROVAL DOCUMENT: Drawing No. **AD12-04**, titled "Series 6001 Alum Sliding Glass Doors – SMP", sheets 1 through 7 of 7, dated MAR 08, 2012, prepared by MCY Engineering, Inc., signed and sealed by Yiping Wang, P. E., bearing the Miami-Dade County Product Control Revision stamp with the Notice of Acceptance number and expiration date by the Miami-Dade County Product Control Section.

MISSILE IMPACT RATING: Small Missile Impact Resistant

LABELING: Each unit shall bear a permanent label with the manufacturer's name or logo, city, state and series and following statement: "Miami-Dade County Product Control Approved", noted herein.

RENEWAL of this NOA shall be considered after a renewal application has been filed and there has been no change in the applicable building code negatively affecting the performance of this product.

TERMINATION of this NOA will occur after the expiration date or if there has been a revision or change in the materials, use, and/or manufacture of the product or process. Misuse of this NOA as an endorsement of any product, for sales, advertising or any other purposes shall automatically terminate this NOA. Failure to comply with any section of this NOA shall be cause for termination and removal of NOA.

ADVERTISEMENT: The NOA number preceded by the words Miami-Dade County, Florida, and followed by the expiration date may be displayed in advertising literature. If any portion of the NOA is displayed, then it shall be done in its entirety.

INSPECTION: A copy of this entire NOA shall be provided to the user by the manufacturer or its distributors and shall be available for inspection at the job site at the request of the Building Official.

This NOA **revises & renews** NOA # **09-0407.06** and consists of this page 1 and evidence pages E-1, as well as approval document mentioned above.

The submitted documentation was reviewed by **Jaime D. Gascon, P.E.**



J. Gascon
8/3/12

NOA No 12-0416.03
Expiration Date: April 03, 2018
Approval Date: August 09, 2012
Page 1

NOTICE OF ACCEPTANCE: EVIDENCE SUBMITTED

A. DRAWINGS

1. Manufacturer's die drawings and sections (submitted under file # **09-0407.06**)
2. Drawing No. **AD12-04**, titled "Series 6001 Alum Sliding Glass Doors – SMI", sheets 1 through 7 of 7, dated MAR 08, 2012, prepared by MCY Engineering, Inc., signed and sealed by Yiping Wang, P.E.

B. TESTS (submitted under file # 09-0407.06)

1. Test reports on:
 - 1) Air Infiltration Test, per FBC, TAS 202-94
 - 2) Uniform Static Air Pressure Test, Loading per FBC TAS 202-94
 - 3) Water Resistance Test, per FBC, TAS 202-94
 - 4) Small Missile Impact Test per FBC, TAS 201-94
 - 5) Cyclic Wind Pressure Loading per FBC, TAS 203-94
 - 6) Forced Entry Test, per FBC 2411 3.2.1, TAS 202-94

Along with marked-up drawings and installation diagram of an alum sliding Glass door, prepared by Hurricane Testing Laboratory, LLC, Test Report No. **HTL 0242-0517-07 (SM140)**, dated 10/17/07, signed and sealed by Vinu J. Abraham, P. E.

C. CALCULATIONS (submitted under file # 09-0407.06)

1. Anchor verification calculations and structural analysis, complying with FBC-2007, prepared by Al-Farooq Corporation, dated 11/27/07 and revised on 02/25/09, signed and sealed by late Dr. Humayoun Farooq, P. E.
2. Glazing complies w/ ASTM E-1300-02 & -04

D. QUALITY ASSURANCE

1. Miami Dade Department of Permitting, Environment, and Regulatory Affairs (PERA).

E. MATERIAL CERTIFICATIONS


1. Notice of Acceptance No. **11-0624.01** issued to E.I. DuPont DeNemours & Co., Inc. for their "**DuPont's Butacite PVB Interlayer**", expiring on 12/11/16.
2. Notice of Acceptance No. **11-0325.05** issued to Solutia, Inc. for their "**Saflex clear & color Interlayer**", expiring on 05/21/16.
3. TREMCO's EPDM gasket (part# TR-1427) complying w/ ASTM C864, ASTM D-412, ASTM D395D and ASTM D 624.

F. STATEMENTS

1. Statement letter of conformance to FBC 2010 and letter of no financial interest dated March 08, 2012, prepared prepared by MCY Engineering, Inc., signed and sealed by Yiping Wang, P.E.
2. Statement letter dated March 01, 2012, of Succeeding Engineer adopting another Engineer's work as her own and responsibilities per Florida Administrative Code, section 61G15-27.001, signed and sealed by Yiping Wang, P.E.
3. Statement letter of conformance to FBC 2007 and letter of no financial interest, prepared by Al Farooq Corporation, dated 02/27/09, signed and sealed by late Dr. Humayoun Farooq, P.E. (submitted under file # **09-0407.06**)
4. Lab compliance as part of the above referenced test report.

G. OTHER

1. This NOA **revises & renews** NOA # **09-0407.06**, expiring on April 03, 2013.

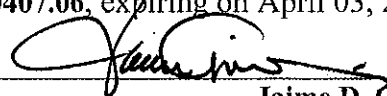

Jaime D. Gascon, P.E.
Product Control Section Supervisor
NOA No 12-0416.03
Expiration Date: April 03, 2018
Approval Date: August 09, 2012

DOORS ARE RATED FOR SMALL MISSILE IMPACT.
 MIAMI-DADE COUNTY APPROVED IMPACT RESISTANT SHUTTERS ARE
 REQUIRED FOR INSTALLATIONS UP TO 30 FT. OF GRADE.
 SHUTTERS NOT REQD. FOR INSTALLATIONS ABOVE 30 FT. OF GRADE.

SERIES-6001 ALUMINUM SLIDING GLASS DOOR

DESIGN LOAD RATING FOR DOORS TO BE AS PER CHART SHOWN
 ON SHEET 2.

THIS PRODUCT HAS BEEN DESIGNED AND TESTED TO COMPLY WITH THE
 REQUIREMENTS OF THE FLORIDA BUILDING CODE INCLUDING
 HIGH VELOCITY HURRICANE ZONE (HVHZ).


WOOD BUCKS BY OTHERS, MUST BE ANCHORED PROPERLY TO TRANSFER
 LOADS TO THE STRUCTURE.

ANCHORS SHALL BE AS LISTED, SPACED AS SHOWN ON DETAILS, ANCHORS
 EMBEDMENT TO BASE MATERIAL SHALL BE BEYOND WALL DRESSING OR STUCCO.

ANCHORING OR LOADING CONDITIONS NOT SHOWN IN THESE DETAILS
 ARE NOT PART OF THIS APPROVAL.

A LOAD DURATION INCREASE IN ALLOWABLE STRESS IS USED IN DESIGN OF
 ANCHORS INTO WOOD ONLY.

MATERIALS INCLUDING BUT NOT LIMITED TO STEEL/METAL SCREWS, THAT COME INTO
 CONTACT WITH OTHER DISSIMILAR MATERIALS SHALL MEET THE REQUIREMENTS
 OF FLORIDA BUILDING CODE SECTION 2003.8.4

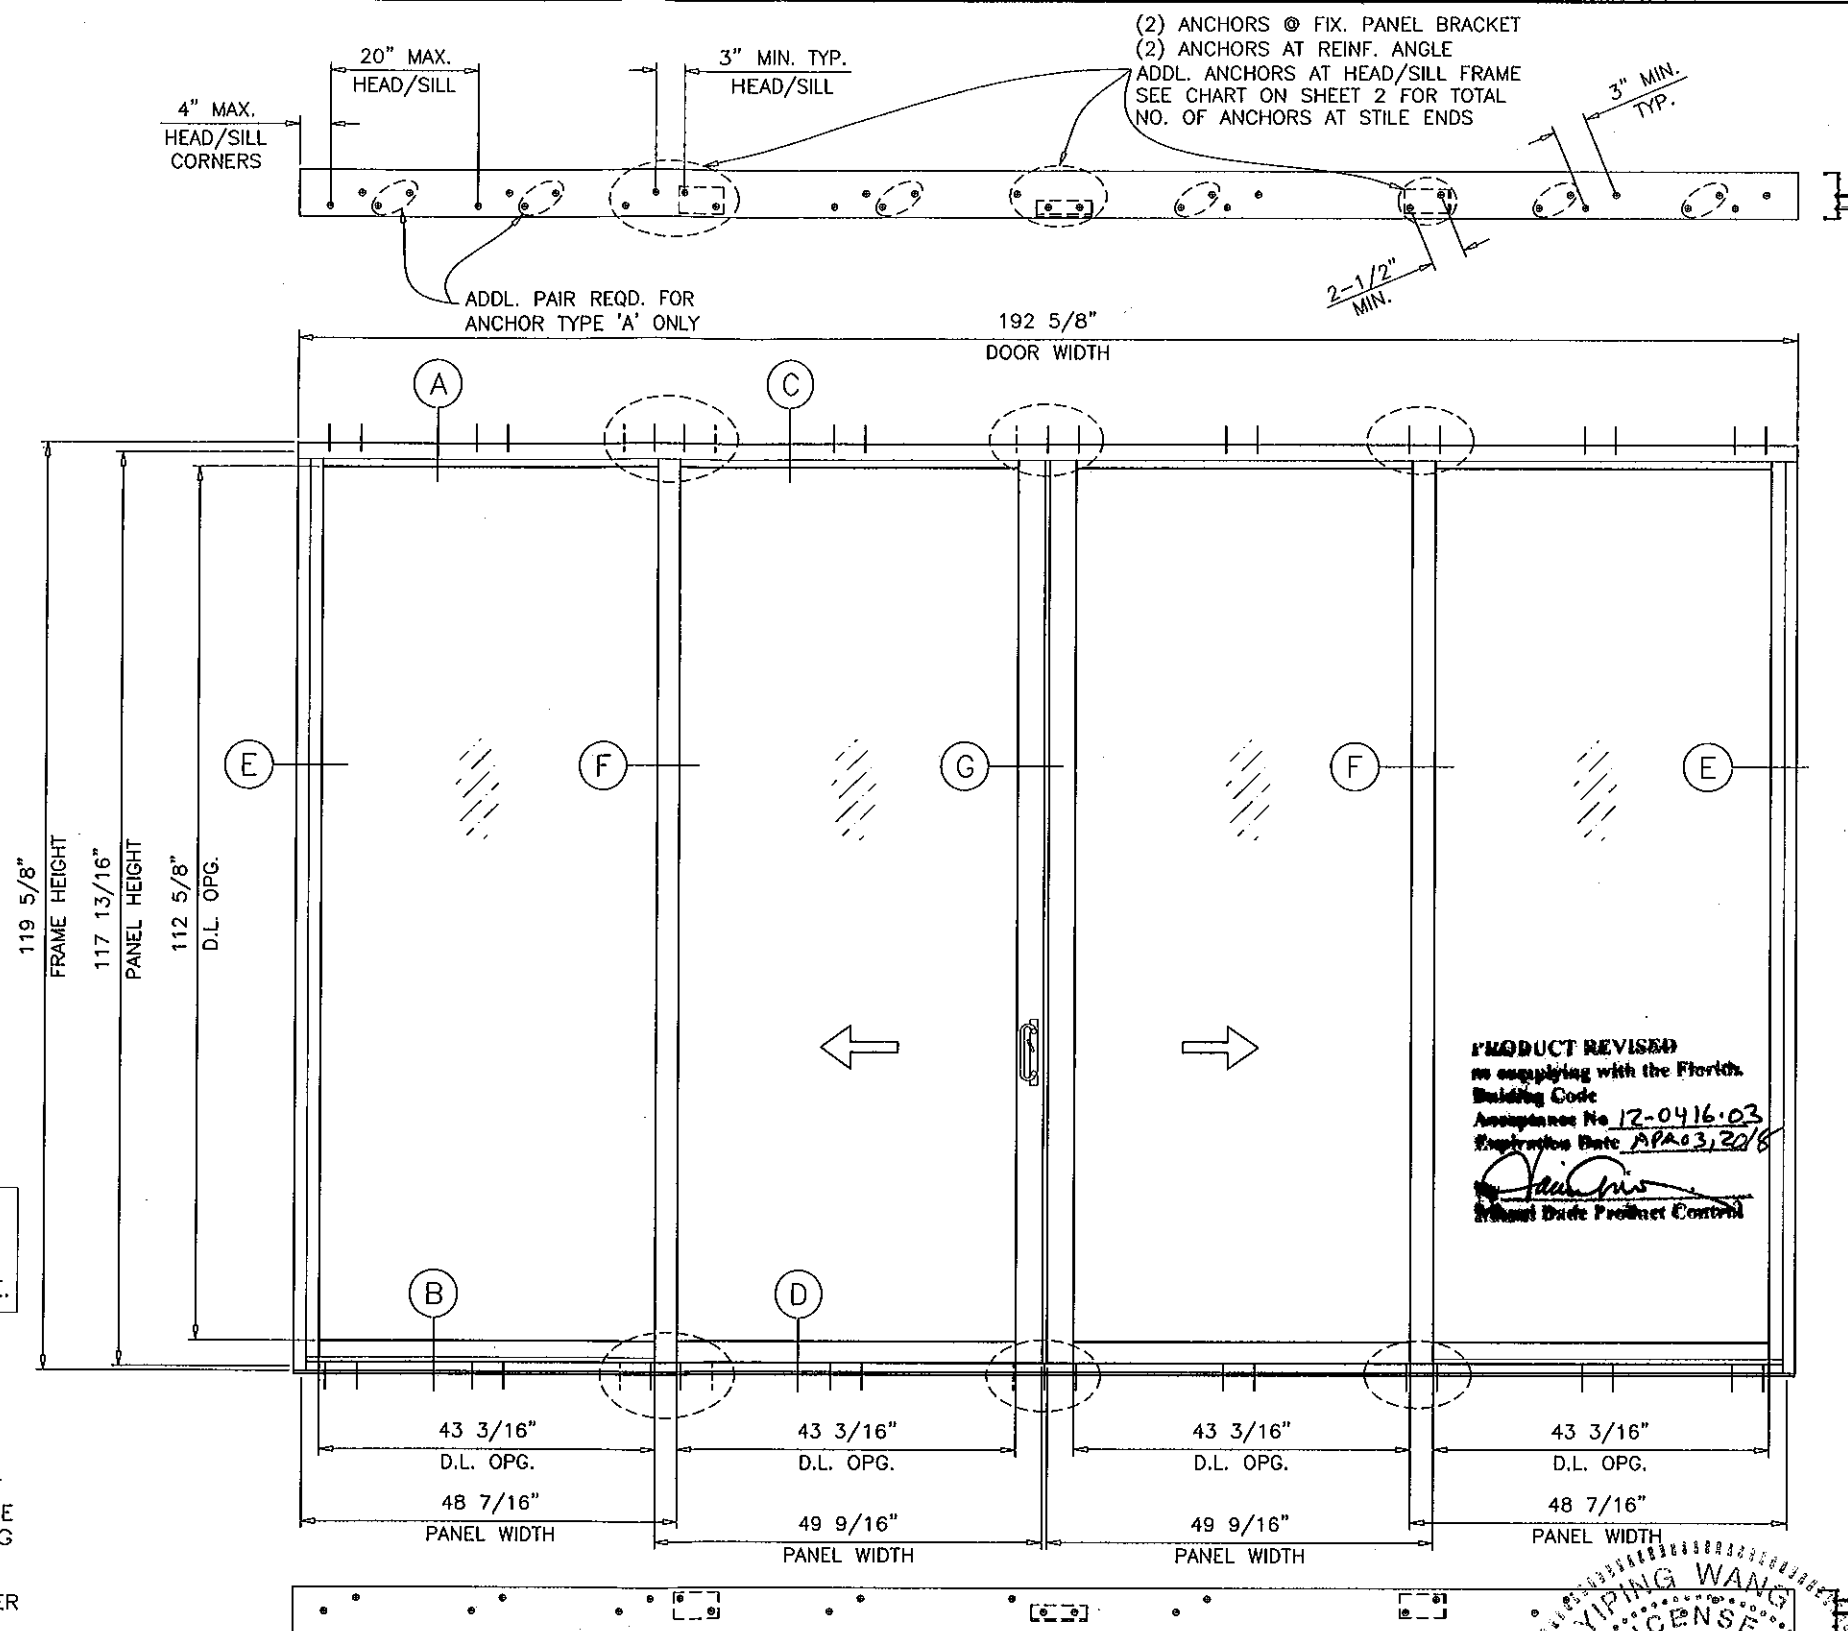

TYPICAL ELEVATION
TESTED UNIT

LAMINATED GLASS
SMALL MISSILE IMPACT

UNANCHORED JAMBS COMPLY WITH DEFLECTION
OF L/180 AND ALLOWABLE STRESS LIMITATION

PRODUCT REVISED
 to comply with the Florida
 Building Code
 Amendment No. 12-0416-03
 Expiration Date: 12/31/16
 YIPING WANG
 Product Control

YIPING WANG
FLORIDA REGISTRATION
 PE #55983
 C.A.N. 28677
STATE OF FLORIDA
PROFESSIONAL ENGINEER
MAR 08 2012

REVISIONS	NO.	DATE	DESCRIPTION

MCY ENGINEERING, INC.
 GLAZING CONSULTANTS
 8501 SW 124 AVE. STE. 205A
 MIAMI, FL 33183
 P: 305.271.0117
 F: 786.573.5063
 www.MCYEngineering.com
 MCY.Engineering@Att.net

NRAP SERIES 6001 SLIDING GLASS DOOR (S.M.I.)
NR ARCHITECTURAL PRODUCTS INC.
 4348 WESTROADS DRIVE
 WEST PALM BEACH, FL 33407
 P: (561) 844-1121 F: (561) 844-6131


DATE	02-20-12
SCALE	AS NOTED
DRAWN	S.L.
PROJECT	12-026
DRAWING NO.	AD12-04
SHEET 1 of 7	

DESIGN LOAD CAPACITY - PSF														
PANEL WIDTH NOMINAL INCHES	DOOR HEIGHT INCHES	ANCHORS TYPE 'A'			ANCHORS TYPE 'B'			ANCHORS TYPE 'C'			ANCHORS TYPE 'D'			
		4 ANCHORS	5 ANCHORS	6 ANCHORS	2 ANCHORS	3 ANCHORS	4 ANCHORS	2 ANCHORS	3 ANCHORS	4 ANCHORS	3 ANCHORS	4 ANCHORS	5 ANCHORS	
		EXT. (+) INT. (-)	EXT. (+) INT. (-)	EXT. (+) INT. (-)	EXT. (+) INT. (-)	EXT. (+) INT. (-)	EXT. (+) INT. (-)	EXT. (+) INT. (-)	EXT. (+) INT. (-)	EXT. (+) INT. (-)	EXT. (+) INT. (-)	EXT. (+) INT. (-)	EXT. (+) INT. (-)	
36	80	117.2	140.0	140.0	137.7	140.0	140.0	140.0	140.0	140.0	140.0	140.0	140.0	
42		105.5	131.9	140.0	124.0	140.0	140.0	140.0	140.0	140.0	131.1	140.0	140.0	
48		97.3	121.6	140.0	114.3	140.0	140.0	140.0	140.0	140.0	120.9	140.0	140.0	
54		91.4	114.2	137.1	107.4	140.0	140.0	132.8	140.0	140.0	113.5	140.0	140.0	
60		87.2	109.0	130.8	102.4	138.6	138.6	126.7	138.6	138.6	108.3	140.0	140.0	
36	84	110.1	137.6	140.0	129.3	140.0	140.0	140.0	140.0	140.0	136.7	140.0	140.0	
42		98.8	123.5	140.0	116.1	140.0	140.0	140.0	140.0	140.0	122.8	140.0	140.0	
48		90.8	113.5	136.2	106.7	140.0	140.0	132.0	140.0	140.0	112.8	140.0	140.0	
54		85.0	106.2	127.4	99.8	140.0	140.0	123.5	140.0	140.0	105.5	140.0	140.0	
60		80.7	100.0	100.0	94.8	100.0	100.0	117.3	100.0	100.0	100.0	100.0	100.0	
36	90	100.9	126.1	140.0	118.6	140.0	140.0	140.0	140.0	140.0	125.3	140.0	140.0	
42		90.2	112.8	135.4	106.0	140.0	140.0	131.2	140.0	140.0	112.1	140.0	140.0	
48		82.5	103.2	123.8	97.0	140.0	140.0	120.0	140.0	140.0	102.5	136.7	140.0	
54		76.9	96.1	115.3	90.3	135.5	140.0	111.7	140.0	140.0	95.5	127.3	140.0	
60		72.6	90.8	100.0	85.4	100.0	100.0	105.6	100.0	100.0	90.2	100.0	100.0	
36	96	93.1	116.4	139.7	109.4	140.0	140.0	135.4	140.0	140.0	115.7	140.0	140.0	
42		83.0	103.8	124.5	97.6	140.0	140.0	120.7	140.0	140.0	103.1	137.5	140.0	
48		75.7	94.6	113.5	88.9	133.4	140.0	110.0	140.0	140.0	94.0	125.3	140.0	
54		70.2	87.7	100.0	82.5	100.0	100.0	102.0	100.0	100.0	87.2	100.0	100.0	
60		66.0	82.5	99.1	77.6	100.0	100.0	96.0	100.0	100.0	82.0	100.0	100.0	
36	102	86.5	108.1	129.7	101.6	140.0	140.0	125.7	140.0	140.0	107.4	140.0	140.0	
42		76.9	96.1	115.3	90.3	135.5	140.0	111.7	140.0	140.0	95.5	127.3	140.0	
48		69.8	87.3	104.8	82.1	123.2	133.2	101.5	133.2	133.2	86.8	115.7	133.2	
54		64.6	80.7	96.9	75.9	100.0	100.0	93.9	100.0	100.0	80.2	100.0	100.0	
36	108	80.7	100.0	100.0	94.8	100.0	100.0	117.3	100.0	100.0	100.0	100.0	100.0	
42		71.6	89.5	100.0	84.1	100.0	100.0	104.0	100.0	100.0	88.9	100.0	100.0	
48		64.9	81.1	97.3	76.2	100.0	100.0	94.3	100.0	100.0	80.6	100.0	100.0	
36	114	75.7	94.6	100.0	88.9	100.0	100.0	110.0	100.0	100.0	94.0	100.0	100.0	
42		66.9	83.7	100.0	78.7	100.0	100.0	97.3	100.0	100.0	83.2	100.0	100.0	
48		60.5	75.7	90.8	71.1	100.0	100.0	88.0	100.0	100.0	75.2	100.0	100.0	
36	120	71.2	89.0	100.0	83.7	100.0	100.0	103.5	100.0	100.0	85.5	100.0	100.0	
42		62.9	78.6	94.3	73.9	100.0	100.0	91.4	100.0	100.0	78.1	100.0	100.0	
48		56.8	70.9	85.1	66.7	100.0	100.0	82.5	100.0	100.0	70.5	94.2	100.0	

NOTE:
GLASS CAPACITIES ON THIS SHEET ARE
BASED ON ASTM E1300-04 (3 SEC. GUSTS)
AND FLORIDA BUILDING COMMISSION
DECLARATORY STATEMENT DCA05-DEC-219

$$\text{PANEL WIDTH NOMINAL} = \frac{\text{DOOR WIDTH}}{\text{NUMBER OF PANELS}}$$


D.L. OPENING
D.L.O. HEIGHT = PANEL HEIGHT - 5.1875"
D.L.O. WIDTH FIX. PANEL = PANEL WIDTH - 5.250"
D.L.O. WIDTH MOV. PANEL = PANEL WIDTH - 6.375"

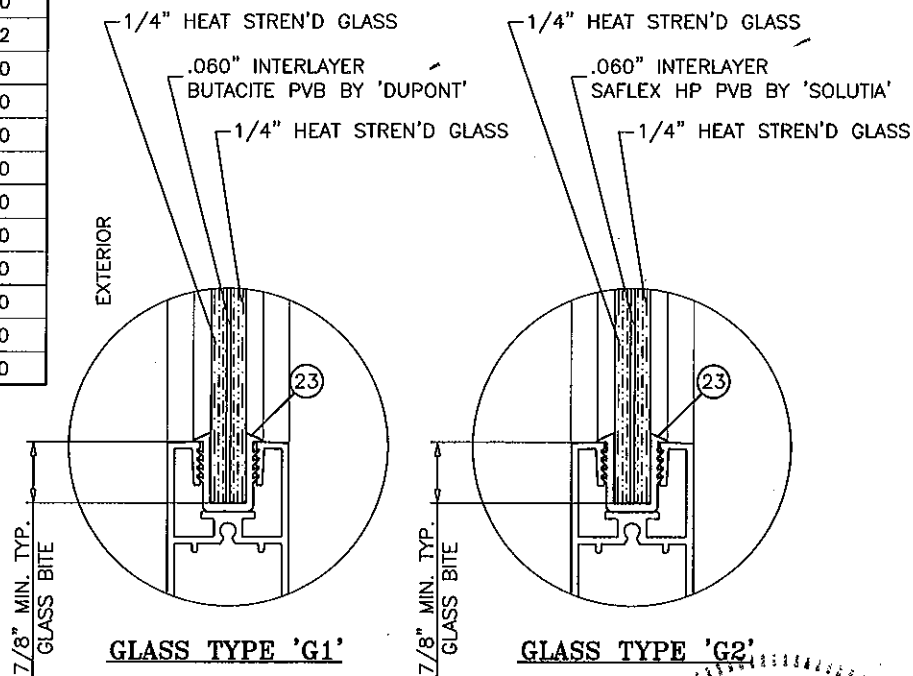

GLAZING OPTIONS

9/16" OVERALL LAMINATED GLASS

PRODUCT REVISED
in compliance with the Florida
Building Code
Acceptance No. 12-0416-03
Expiration Date 4/3/18
Professional Engineer
Michael Wade Proctor Control

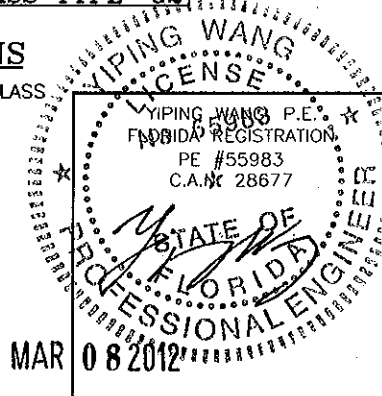


REVISIONS	DESCRIPTION
NO.	DATE







MCY ENGINEERING, INC.
GLAZING CONSULTANTS
8501 SW 124 AVE. STE. 205A
MIAMI, FL 33183
P: 305.271.0117
F: 786.573.5063
www.MCYEngineering.com
MCY.Engineering@Att.net

NR ARCHITECTURAL PRODUCTS INC.
4348 WESTROADS DRIVE
WEST PALM BEACH, FL 33407
P: (561) 844-1121 F: (561) 844-6131

DATE	02-20-12
SCALE	AS NOTED
DRAWN	S.I.
PROJECT	12-026
DRAWING NO.	AD12-04
SHEET	2 of 7

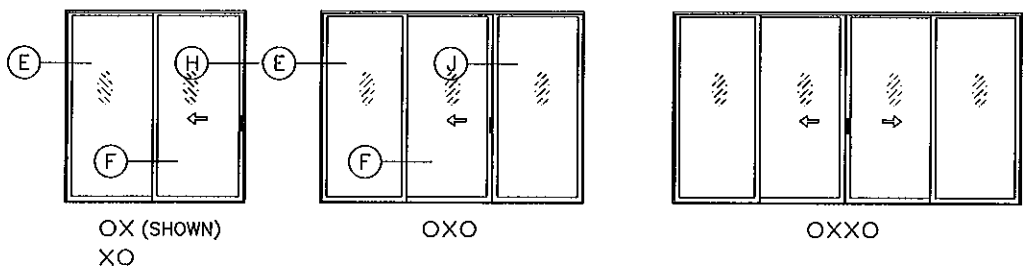

APPROVED CONFIGURATIONS

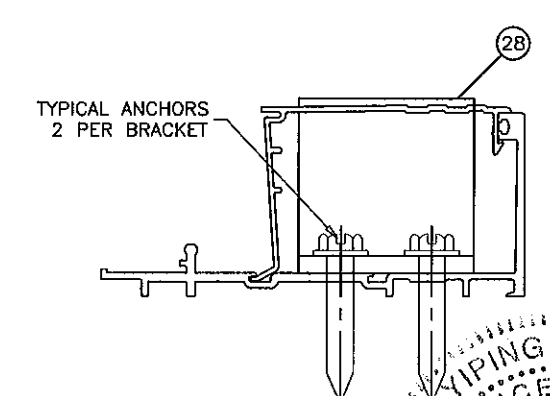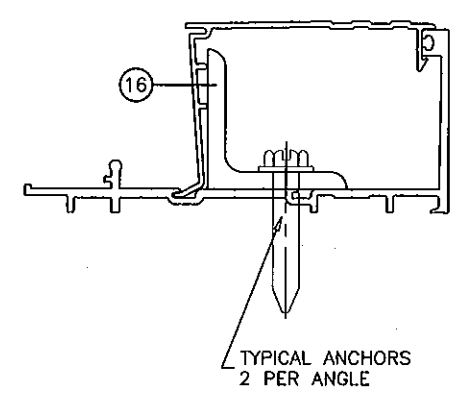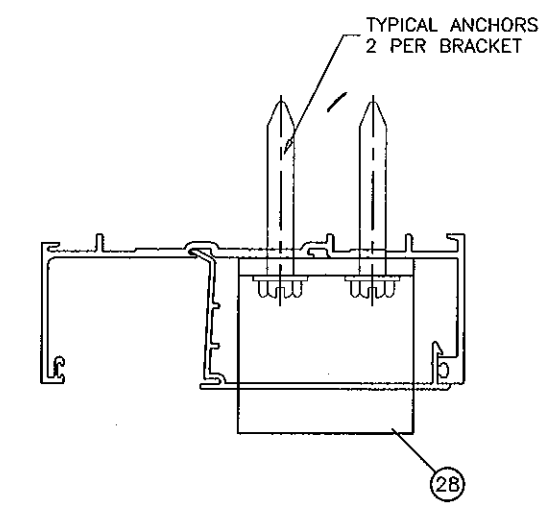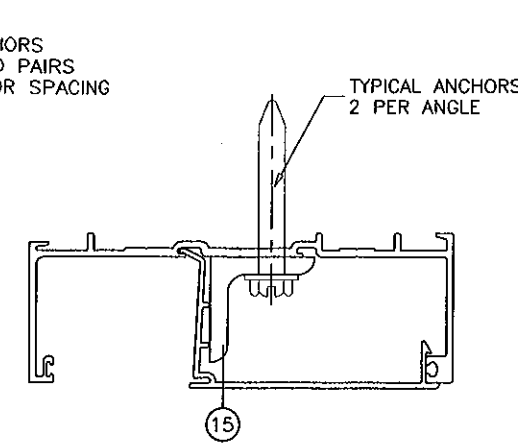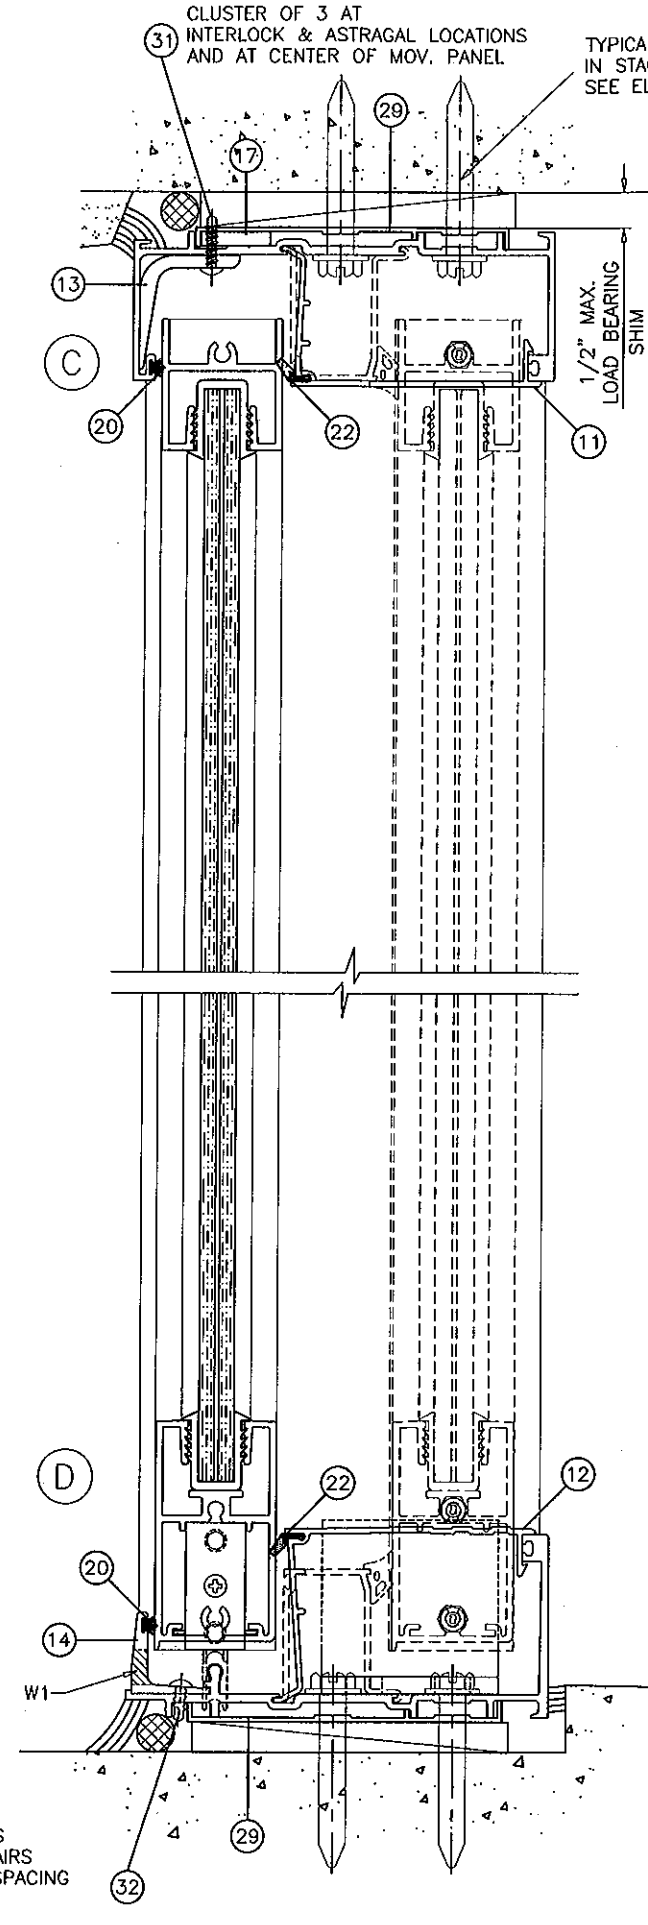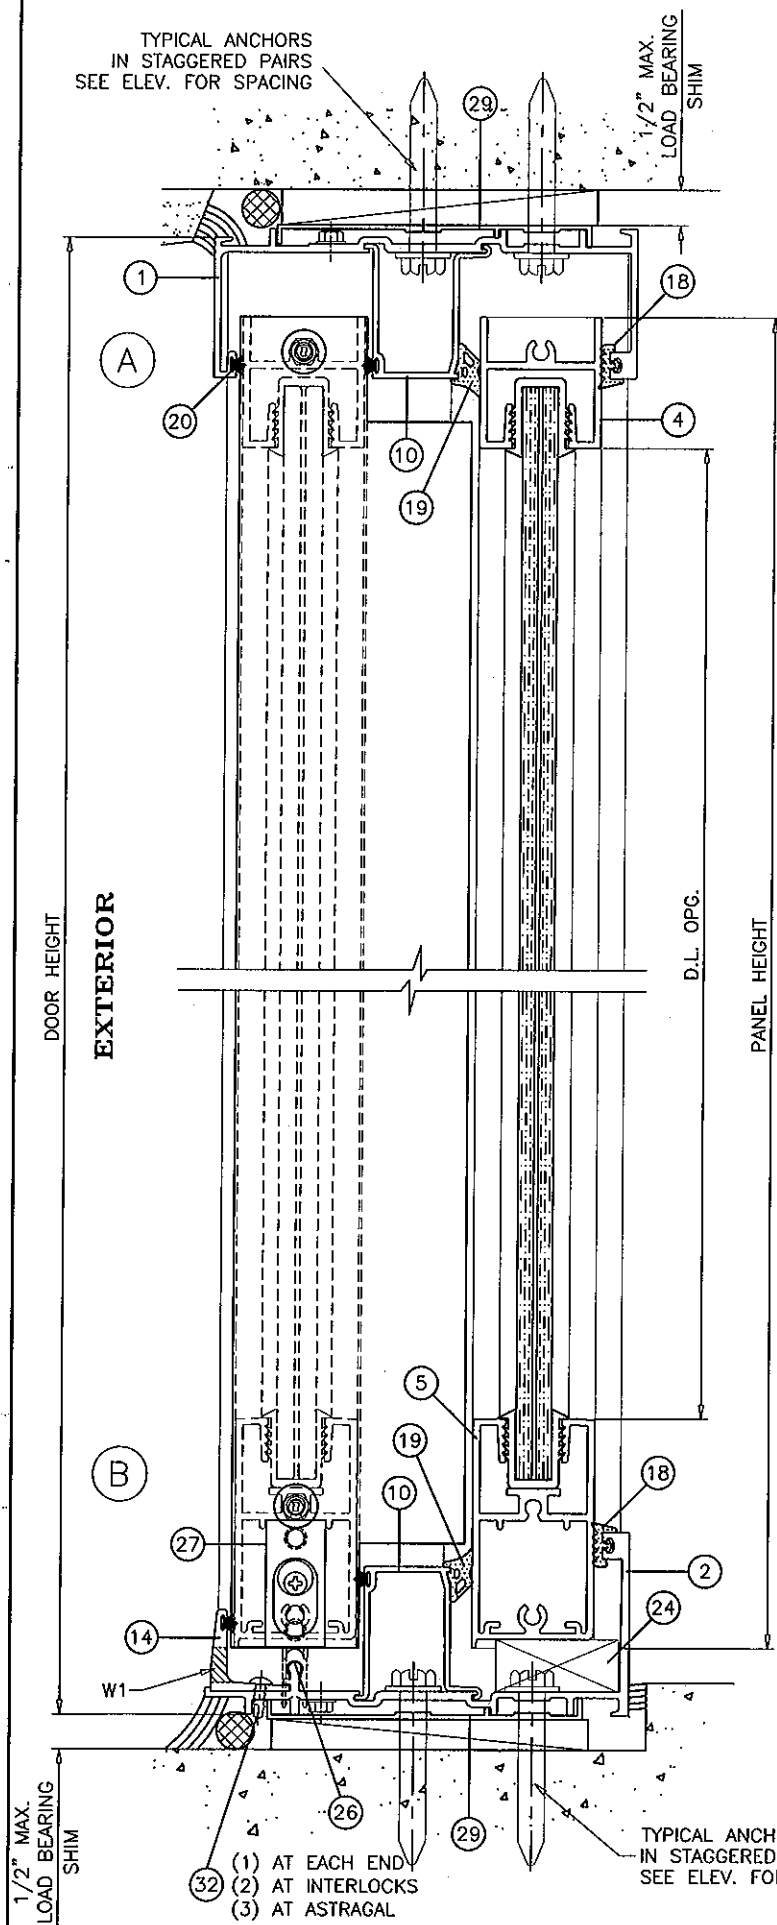

PRODUCT REVISED
to comply with the Florida
Building Code
Acceptance No 12-0416-03
Expiration Date 4/3/12




YIPING WANG
LICENSE
YIPING WANG
FLORIDA REGISTRATION
PE #58983
C.A.N. 28677
STATE OF
FLORIDA
PROFESSIONAL ENGINEER
MAR 08 2012

REVISIONS		NO. DATE		DESCRIPTION	

MCY ENGINEERING, INC.		GLAZING CONSULTANTS	
8501 SW 124 AVE. STE. 205A		P: 305.271.0117	
MIAMI, FL 33183		F: 786.573.5063	
www.MCYEngineering.com		MCY.Engineering@Att.net	

NR ARCHITECTURAL PRODUCTS INC.		4348 WESTROADS DRIVE	
WEST PALM BEACH, FL 33407		P: (561) 844 - 1121	
		F: (561) 844 - 6131	

DATE	02-20-12
SCALE	AS NOTED
DRAWN	S.L.
PROJECT	12-026
DRAWING NO.	AD12-04
SHEET	3 of 7

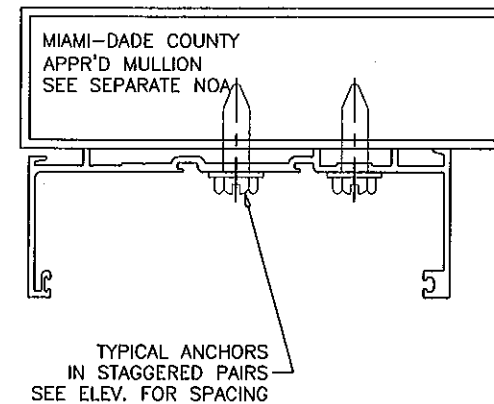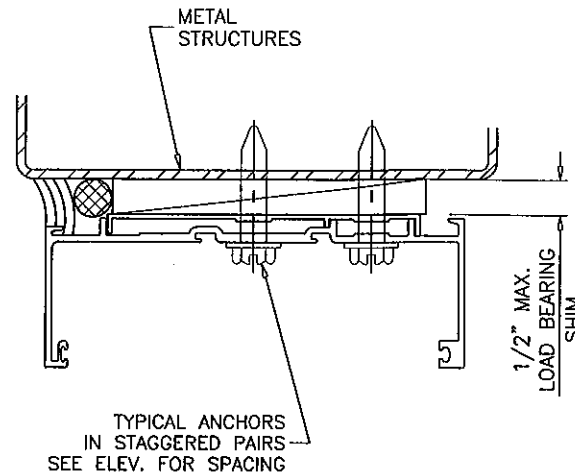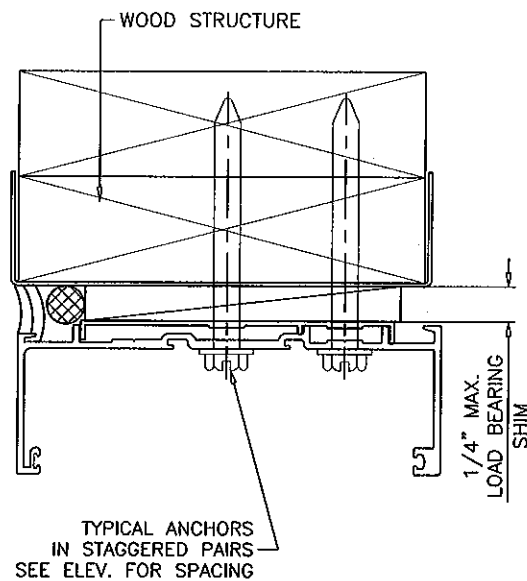

WOOD BUCKS AND METAL STRUCTURES NOT BY N.R. WDW.
MUST SUPPORT LOADS IMPOSED BY GLAZING SYSTEM AND
TRANSFER THEM TO THE BUILDING STRUCTURE.

TYPICAL ANCHORS: SEE ELEV. FOR SPACING

- TYPE 'A' - 3/8" DIA. LAG SCREWS ($F_y = 45$ KSI)
INTO WOOD STRUCTURES
WITH 2-1/4" MIN. PENETRATION INTO WOOD
- TYPE 'B' - 3/8" DIA. POWERS WEDGE-BOLT ANCHOR
DIRECTLY INTO CONCRETE ($f_c' = 3000$ PSI MIN.)
WITH 1-1/2" MIN. EMBED INTO CONC.
- TYPE 'C' - 3/8" DIA. SCREWS GRADE 5
INTO METAL STRUCTURES
STEEL : 1/4" THK. MIN. ($F_y = 36$ KSI MIN.)
ALUMINUM : 1/4" THK. MIN. (6063-T5 MIN.)
(STEEL IN CONTACT WITH ALUMINUM TO BE PLATED OR PAINTED)
- TYPE 'D' - 5/16" DIA. TAPCON BY 'ITW' ($F_u = 120$ KSI, $F_y = 92$ KSI)
INTO WOOD STRUCTURES
WITH 2-1/4" MIN. PENETRATION INTO WOOD
- ANCHOR EDGE DISTANCES**
INTO CONCRETE = 3" MIN.
INTO WOOD STRUCTURE = 1-1/2" MIN.
INTO METAL STRUCTURE = 1" MIN.


SEALANTS:

ALL FRAME CORNERS AND JOINTS SEALED WITH
DOW-795 OR TREMCO SPECTREM 2 SILICONE SEALANT.

WEEPHOLES:

- W1 = 1-1/2" X 1/2" WEEP SLOTS
(1) AT CENTER OF EACH PANEL
(1) AT EACH SIDE OF INTERLOCK
(1) AT ASTRAGAL STILE

PRODUCT REVIEWED
as complying with the Florida
Building Code
Acceptance No. 12-0416-03
Expiration Date 4/3/18
By [Signature]
Miami Dade Product Control

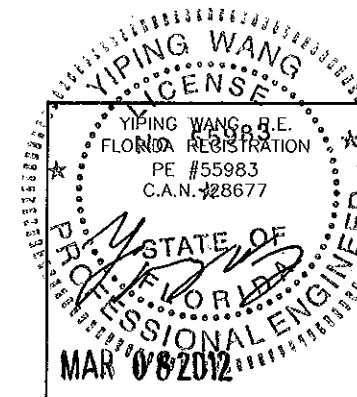

REVISIONS	
NO.	DATE

MCY ENGINEERING, INC.
GLAZING CONSULTANTS

8501 SW 124 AVE. STE. 205A
MIAMI, FL 33183


P: 305.271.0117
F: 786.573.5063

www.MCYEngineering.com
MCY.Engineering@Att.net



NRAP SERIES 6001 SLIDING GLASS DOOR (S.M.I.)

NR ARCHITECTURAL PRODUCTS INC.
4348 WESTROADS DRIVE
WEST PALM BEACH, FL 33407
P: (561) 844-1121 F: (561) 844-6131


DATE	02-20-12
SCALE	AS NOTED
DRAWN	S.L.
PROJECT	12-028
DRAWING NO.	
AD12-04	
SHEET 4 of 7	

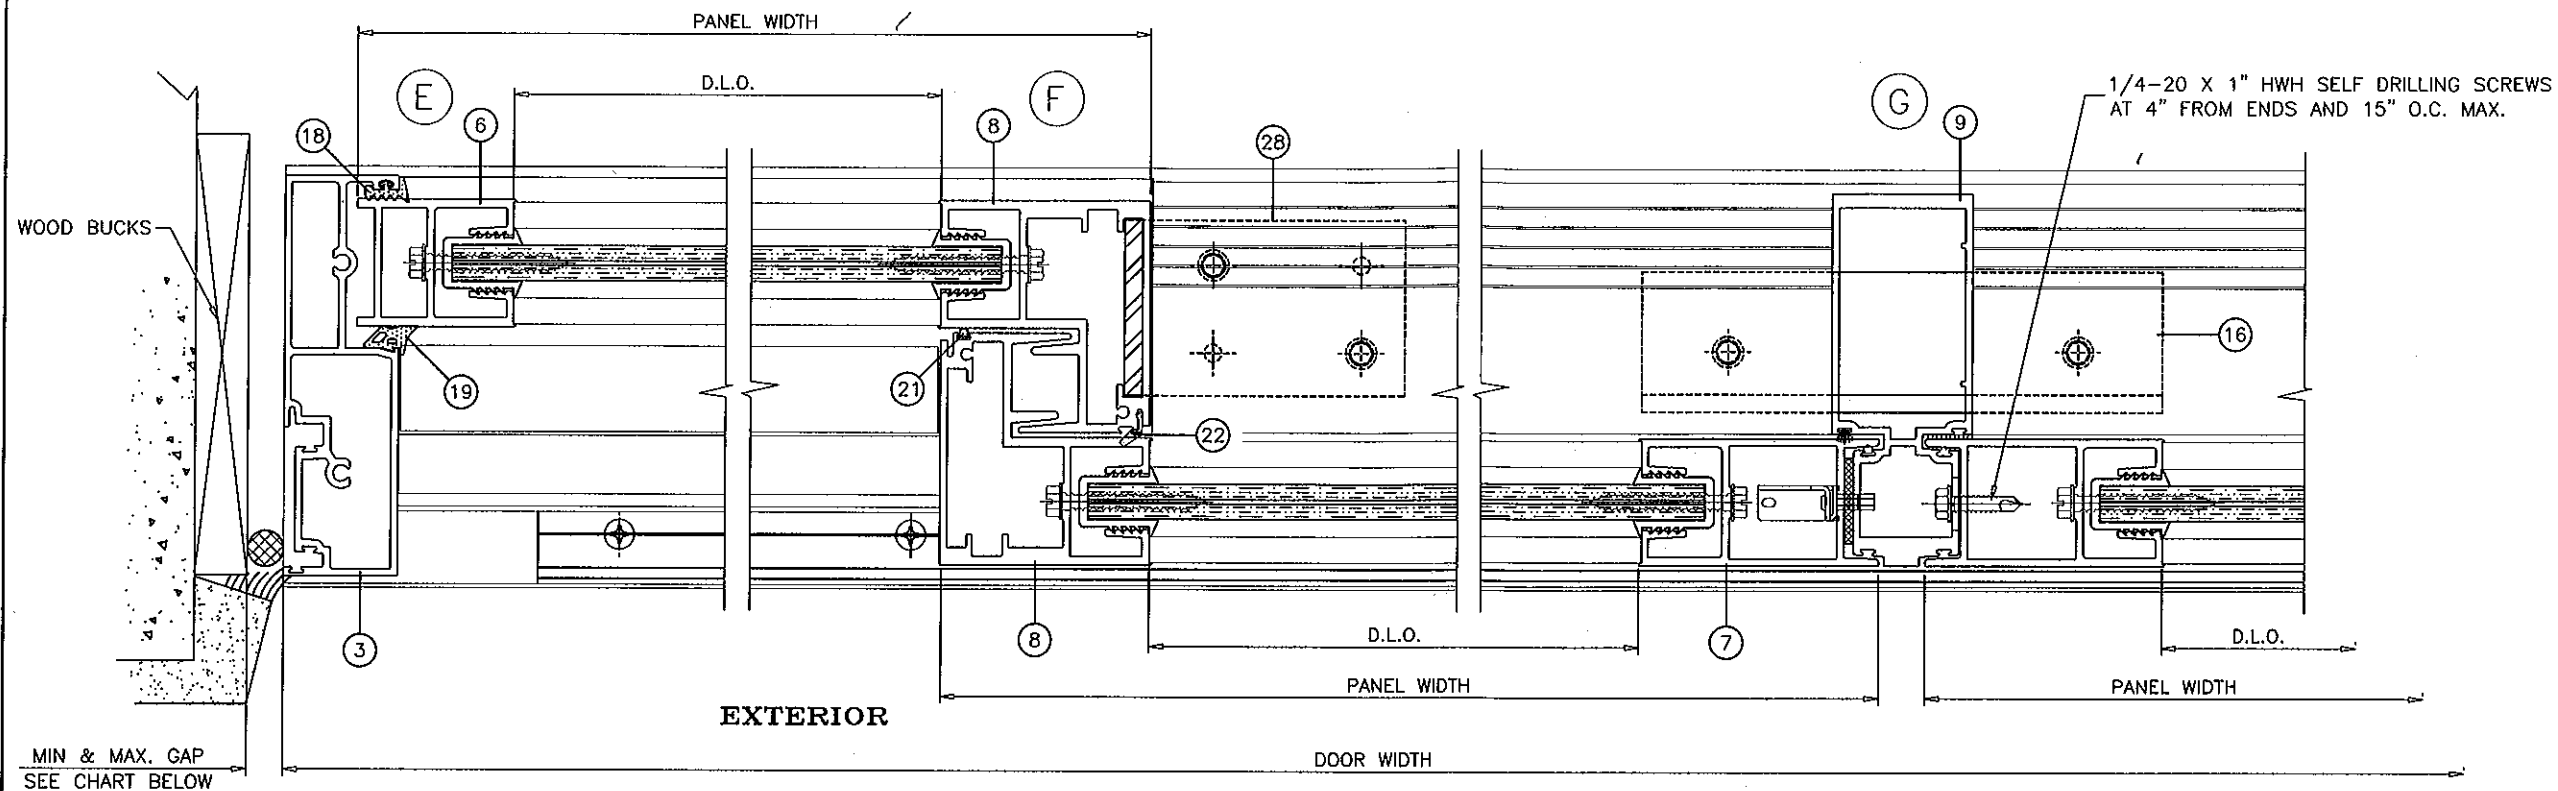

MAX. FRAME HEIGHT	GAP	
	MIN.	MAX.
114"	3/8"	1/2"
119 5/8"	1/2"	3/4"

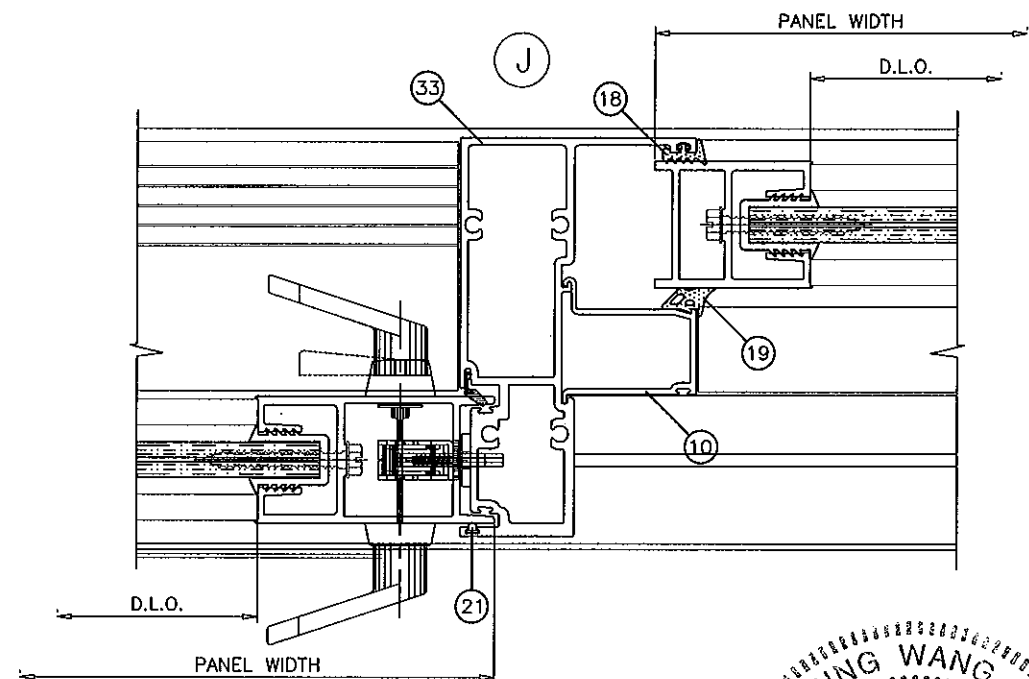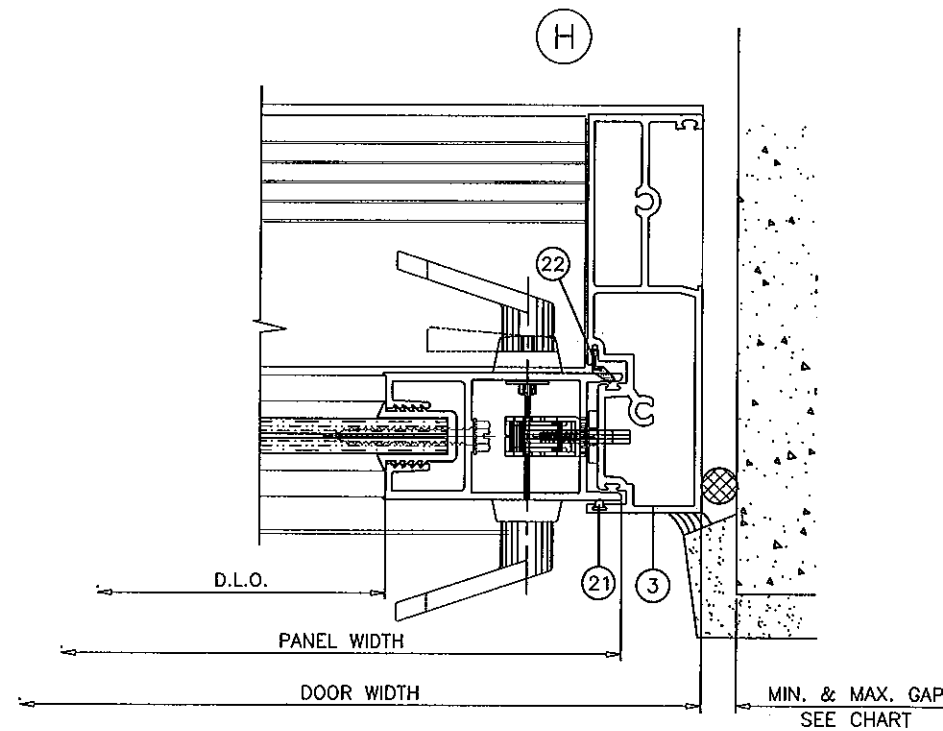

PRODUCT REVISED
to comply with the Florida
Building Code
Adoption No 12-0416-03
Registration Date 4/3/18
[Signature]
Product Control

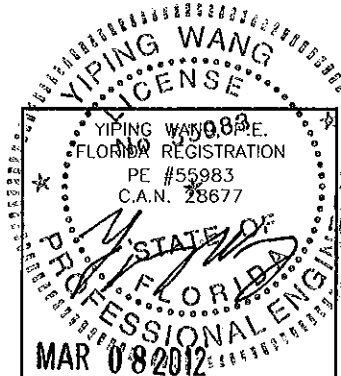

REVISIONS	
NO.	DESCRIPTION

MCY ENGINEERING, INC.
GLAZING CONSULTANTS

MCY

8501 SW 124 AVE. STE. 205A
MIAMI, FL 33183

P: 305.271.0117
F: 786.573.5063

www.MCYEngineering.com
MCY.Engineering@Att.net


NR ARCHITECTURAL PRODUCTS INC.

NRAP SERIES 6001 SLIDING GLASS DOOR (S.M.I.)


4348 WESTROADS DRIVE
WEST PALM BEACH, FL 33407

P: (561) 844 - 1121 F: (561) 844 - 6131


DATE	02-20-12
SCALE	AS NOTED
DRAWN	S.I.
PROJECT	12-026
DRAWING NO.	AD12-04
SHEET	5 of 7

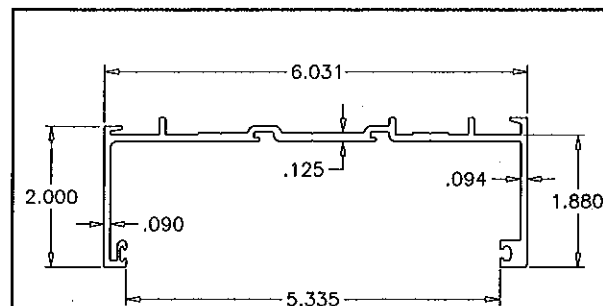


① FRAME HEAD

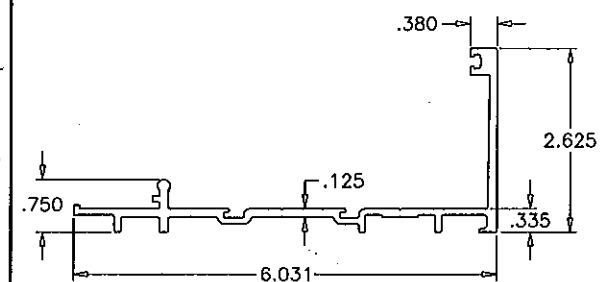


② FRAME SILL

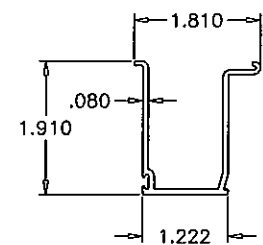


⑩ FIX. PANEL STOP

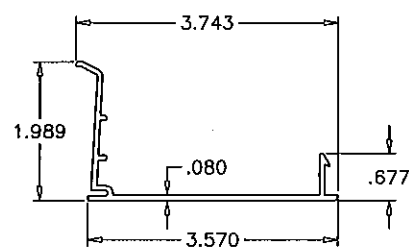


⑪ HEAD TRIM

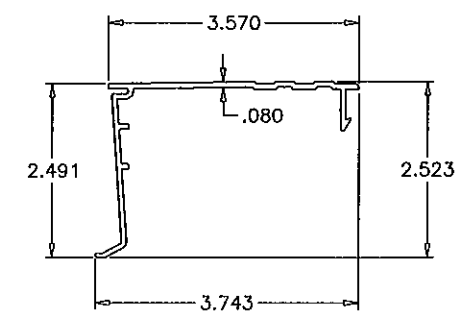


⑫ SILL THRESHOLD TRIM

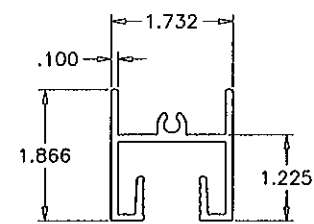


④ PANEL TOP RAIL

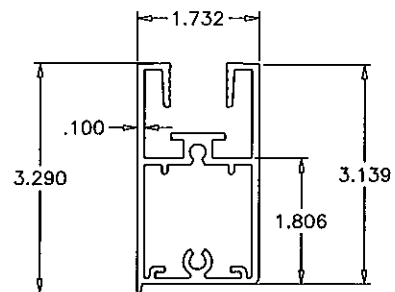


⑤ PANEL BOTTOM RAIL

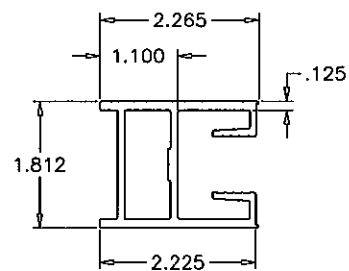


⑥ FIX. PANEL JAMB STILE

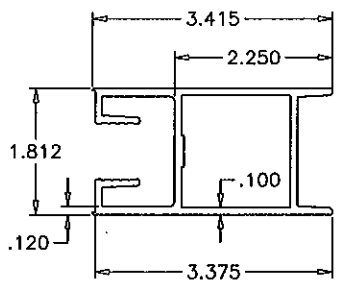


⑦ OPERATING PANEL JAMB STILE

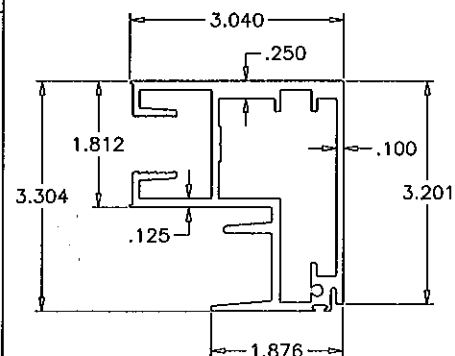


⑧ INTERLOCK STILE

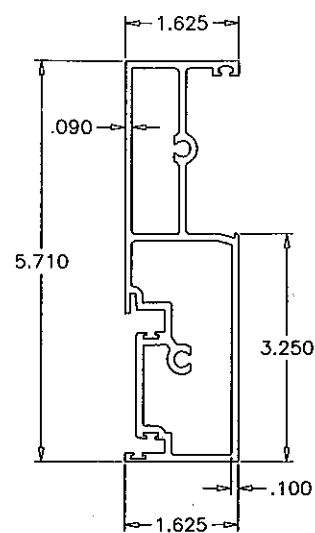


③ FRAME JAMB

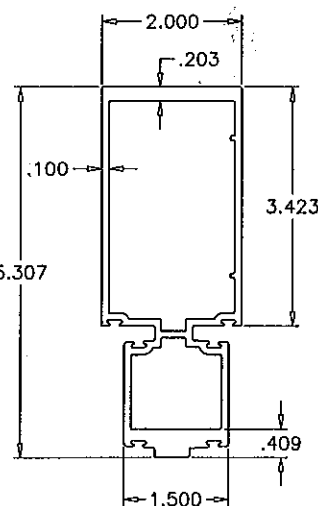


⑨ ASTRAGAL

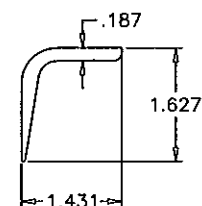


⑬ HEAD ANTI-BLOWOUT CLIP

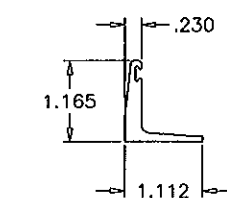


⑭ SILL ANTI-BLOWOUT CLIP

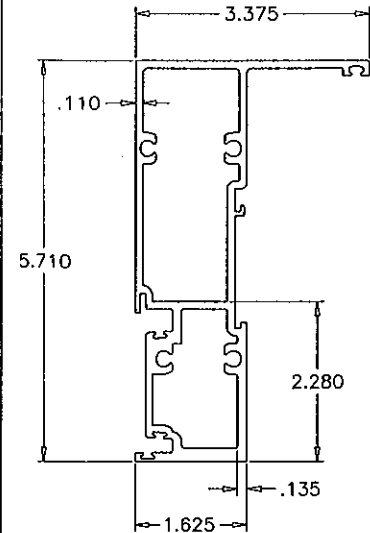


③③ OXO LOCK STILE

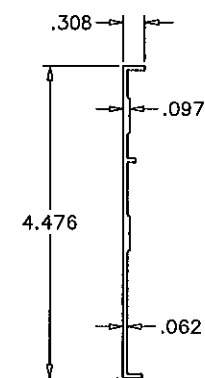

②⑨ SHEAR CLIP

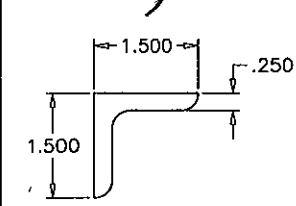


⑮ HEAD ANGLE

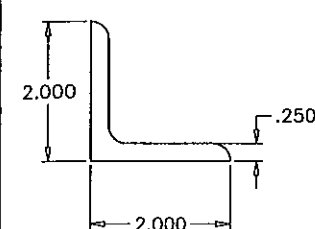

⑮ SILL ANGLE

PRODUCT REVISED
in compliance with the Florida
Building Code
Acceptance No. 12-0416-03
Expiration Date 4/3/18
By [Signature]
Manual Date Product Control

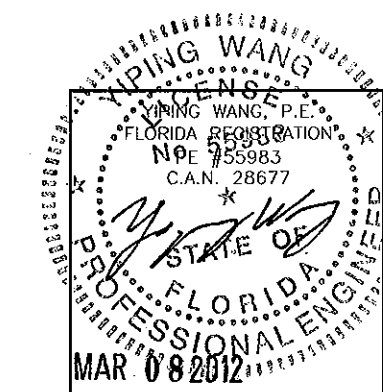

REVISIONS	
NO.	DESCRIPTION

MCY ENGINEERING, INC.
GLAZING CONSULTANTS

MCY



8501 SW 124 AVE. STE. 205A P: 305.271.0117
MIAMI, FL 33183 F: 786.573.5063
www.MCYEngineering.com MCY.Engineering@Att.net

NRAP SERIES 6001 SLIDING GLASS DOOR (S.M.I.)

NR ARCHITECTURAL PRODUCTS INC.


4348 WESTROADS DRIVE
WEST PALM BEACH, FL 33407
P: (561) 844 - 1121 F: (561) 844 - 6131

DATE	02-20-12
SCALE	AS NOTED
DRAWN	S.L.
PROJECT	12-026
DRAWING NO.	
AD12-04	
SHEET 6 of 7	

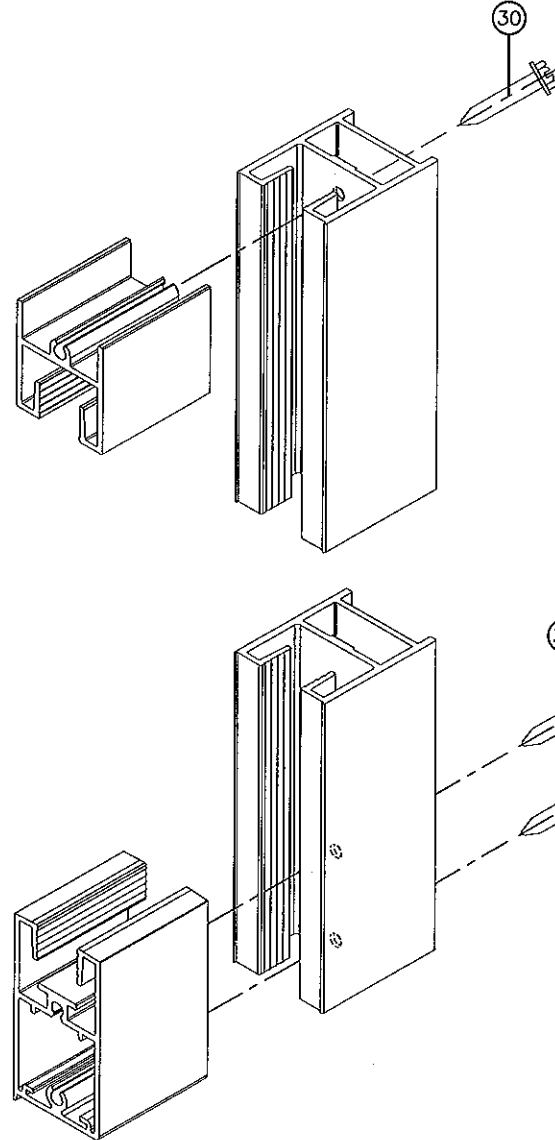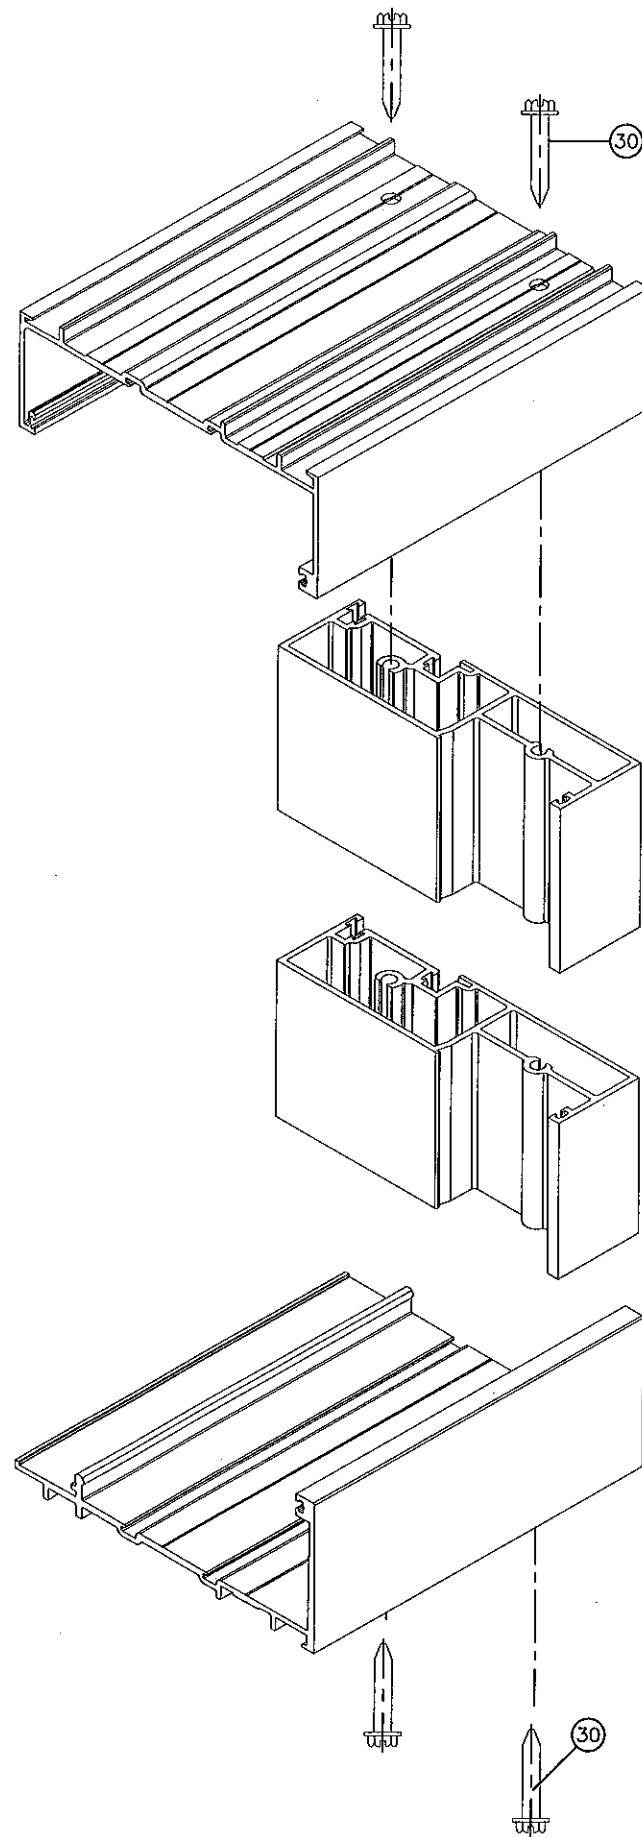

ITEM #	PART #	QUANTITY	DESCRIPTION	MATERIAL	MANF./SUPPLIER/REMARKS
1	SD-001	1	FRAME HEAD	6005-T5	-
2	SD-002	1	FRAME SILL	6005-T5	-
3	SD-003	1	FRAME JAMB	6005-T5	-
4	SD-006	2/ PANEL	TOP RAIL	6005-T5	-
5	SD-007	2/ PANEL	BOTTOM RAIL	6005-T5	-
6	SD-008	AS REQD.	FIX. PANEL JAMB STILE	6005-T5	-
7	SD-010	AS REQD.	OPERATING PANEL JAMB STILE	6005-T5	-
8	SD-009	AS REQD.	INTERLOCK STILE	6005-T5	-
9	SD-005	AS REQD.	ASTRAGAL STILE	6005-T5	-
10	SD-011	AS REQD.	FIX. PANEL STOP	6005-T5	-
11	SD-013	-	HEAD TRIM	6005-T5	-
12	SD-012	-	SILL THRESHOLD TRIM	6005-T5	-
13	SD-014	1	HEAD ANTI-BLOWOUT CLIP	6005-T5	AT MOV. PANELS ONLY
14	SD-015	1	SILL ANTI-BLOWOUT CLIP	6005-T5	LENGTH = FRAME WIDTH - 9"
15	NR-A1	-	HEAD REINF. ANGLE	STEEL	7-3/8" LONG
16	NR-A2	-	SILL REINF. ANGLE	STEEL	7-3/8" LONG
17	NR-A3	-	BACK UP PLATE	ALUM	1 X 4 X 1/4"
18	NR-G8	AS REQD.	PRESET GASKET	EPDM SPONGE	TR-15094E
19	NR-G9	AS REQD.	WEDGE GASKET	EPDM 70 DURO	TR-0436E
20	NR-G10	AS REQD.	FINPILE W'STRIPPING (.187W X .260H)	-	-
21	NR-G11	AS REQD.	BULB GASKET	VINYL	Q200T190 Q-LON
22	NR-G12	AS REQD.	FINGER GASKET	-	QE2D 250 Q-LON
23	NR-G13	AS REQD.	GLAZING GASKET	80 DURO	TR-15292W
24	NR-G15	AS REQD.	FIX. PANEL SETTING BLOCK	EPDM 80 DURO	4" LONG
25	NR-G16	AS REQD.	DOOR STOP	-	-
26	NR-A4	-	TRACK COVER	ST/ST	-
27	NR-A5	2/ MOV. PANEL	DUAL TANDEM ROLLER ASSEMBLY	ST/ST	DELTA
28	NR-A6	-	FIX. PANEL ANGLE BRACKET	ALUM	3 X 4 X 1/4" X 2-1/2" LONG
29	NR-A7	AS REQD.	SHEAR CLIP CONTINUOUS	6005-T5	-
30	NR-F4	AS REQD.	FRAME/PANEL ASSEMBLY SCREWS	-	1/4-20 X 1-1/2" HWH TC
31	NR-F5	-	HEAD ANTI-BLOWOUT CLIP FASTENERS	-	1/4-20 X 3/4" HWH MS
32	NR-F6	-	SILL ANTI-BLOWOUT CLIP FASTENERS	-	#12 X 1/4" X 1/2" PHP SMS
33	SD-004	AS REQD.	OXO PANEL LOCK STILE	6005-T5/	-
34	-	AS REQD.	MULTI POINT LOCK	ST. STEEL	AMESBURY

PRODUCT REVISED
 as complying with the Florida
 Building Code
 Acceptance No 12-0416-03
 Expiration Date 03/20/18
 [Signature]
 Manual Draft Product Control

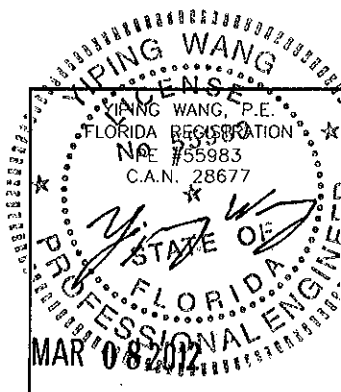

REVISIONS		MCY MCY ENGINEERING, INC. GLAZING CONSULTANTS 8501 SW 124 AVE. STE. 205A MIAMI, FL 33183 P: 305.271.0117 F: 786.573.5063 www.MCYEngineering.com MCY.Engineering@Att.net
NO.	DATE	
DESCRIPTION		
NRAP SERIES 6001 SLIDING GLASS DOOR (S.M.I.) NR ARCHITECTURAL PRODUCTS INC. 4348 WESTROADS DRIVE WEST PALM BEACH, FL 33407 P: (561) 844-1121 F: (561) 844-6131		
DATE	02-20-12	
SCALE	AS NOTED	
DRAWN	S.L.	
PROJECT	12-026	
DRAWING NO.		
AD12-04		
SHEET 7 of 7		